

TOWNSHIP OF HAMPTON

RESOLUTION NO. 952

A RESOLUTION OF THE TOWNSHIP OF HAMPTON, COUNTY OF ALLEGHENY, COMMONWEALTH OF PENNSYLVANIA, ADOPTING AND ACCEPTING FOR PUBLIC DEDICATION THOSE CERTAIN "AS-BUILT" SANITARY LINES AS DESCRIBED HEREIN, AS CONSTRUCTED IN THE WHISPERING CREEK PLAN.

WHEREAS, pursuant to prior Township Approval, Developer caused to be constructed sanitary sewer lines and associated improvements to service the properties located within the Whispering Creek Plan, including those sanitary sewer lines and associated easements and/or rights-of-way, as depicted in the attached "*Utility Plans for the Whispering Creek Estates*", situate in the Township of Hampton, Allegheny County, Pennsylvania, prepared by Hampton Technical Associates Inc. with revision date of April 24, 2007", attached hereto as Exhibit "A" hereof, all of which are located within such easements and rights-of-way as established by the recorded Plan;

WHEREAS, upon completion of construction of said sewers, the Township Engineer has examined and approved said sanitary sewer "As-Builts" and has thus recommended formal acceptance of said specified proposed public portion(s) of said sanitary sewers for public ownership and maintenance, as reflected in the as-built Drawings attached hereto as Exhibit "A" hereof.

NOW, THEREFORE, Be it Resolved and adopted by the Township of Hampton, Allegheny County, Commonwealth of Pennsylvania, as follows:

Article I. That the Township of Hampton does hereby accept for dedication to the public, as public improvements of the Township of Hampton, for ownership and maintenance by the Township of Hampton, those certain described sanitary sewers and associated easements and rights-of-way "as-built" in the Whispering Creek Plan, including only those sanitary sewer lines or portions thereof as depicted in the attached Exhibit "A" hereof.

Article II. This RESOLUTION shall take effect immediately in accordance with the law.

IN WITNESS WHEREOF, the present Resolution has been duly adopted by a unanimous vote of the Township of Hampton Council in public session duly convened this 21st day of December, 2016.

ATTEST:

Township of Hampton Council



W. Christopher Lochner
Municipal Manager



Council President

(seal)



DATE	12/31/2024
PROJECT	WINDING CREEK DEVELOPMENT, LLC
SCALE	AS SHOWN
BY	[Signature]
CHECKED BY	[Signature]
DATE	12/31/2024

HAMPTON
TECHNICAL ASSOCIATES, INC.
1000 ...
P.O. Box ...
Hampton, PA 17032
TEL: 717-533-1234
FAX: 717-533-5678
www.hampton-technical.com

CITY OF HAMPTON
WINDING CREEK DEVELOPMENT, LLC
WHISPERING CREEK ESTATES
UTILITY PLAN
ALLEGANY COUNTY, PENNSYLVANIA
PROJECT NO. 2024-001
DATE: 12/31/2024
SCALE: AS SHOWN
BY: [Signature]
CHECKED BY: [Signature]

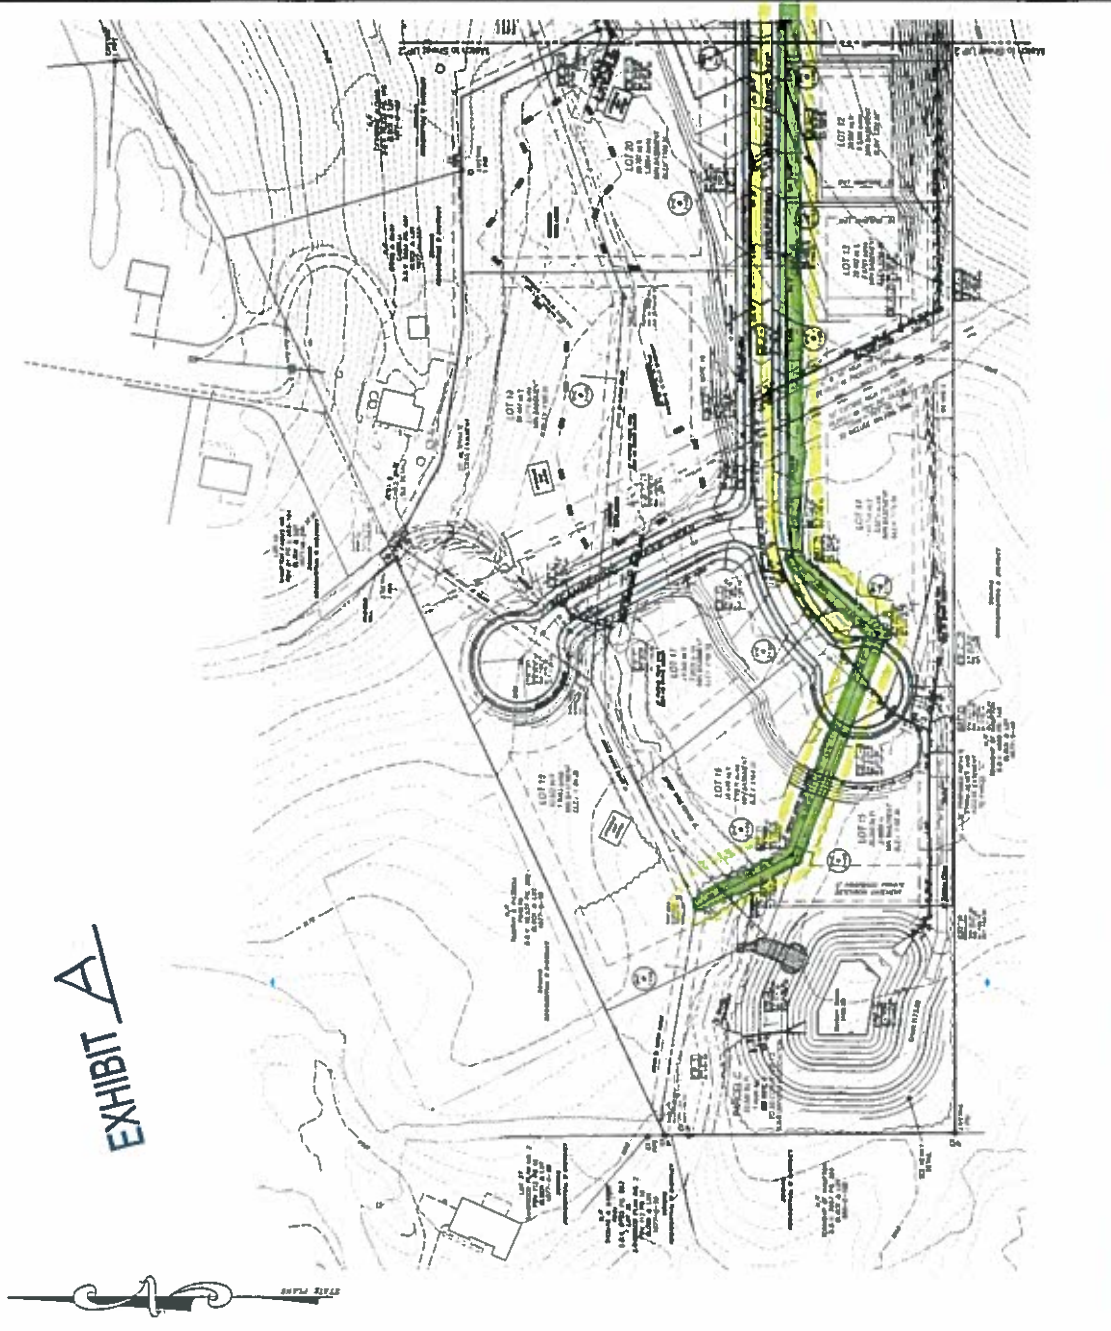


EXHIBIT A

EXHIBIT



GRAPHIC SCALE
0 10 20 30 40 50 FEET



NO. 1	
NO. 2	
NO. 3	
NO. 4	
NO. 5	
NO. 6	
NO. 7	
NO. 8	
NO. 9	
NO. 10	
NO. 11	
NO. 12	
NO. 13	
NO. 14	
NO. 15	
NO. 16	
NO. 17	
NO. 18	
NO. 19	
NO. 20	
NO. 21	
NO. 22	
NO. 23	
NO. 24	
NO. 25	
NO. 26	
NO. 27	
NO. 28	
NO. 29	
NO. 30	

BRONKHORST ENGINEERING
 ENGINEERS AND ARCHITECTS
 1200 GARDNER AVENUE, SUITE 200
 HAVERTY, PENNSYLVANIA 19340
 PH: 610-326-1100
 FAX: 610-326-1105
 WWW.BRONKHORST-PA.COM

WHISPERING CREEK ESTATES
UTILITY PLAN
HAMPTON TOWNSHIP, PENNSYLVANIA
 PLANNED BY: WHISPERING CREEK ESTATES, LLC
 PROJECT NO. 04770

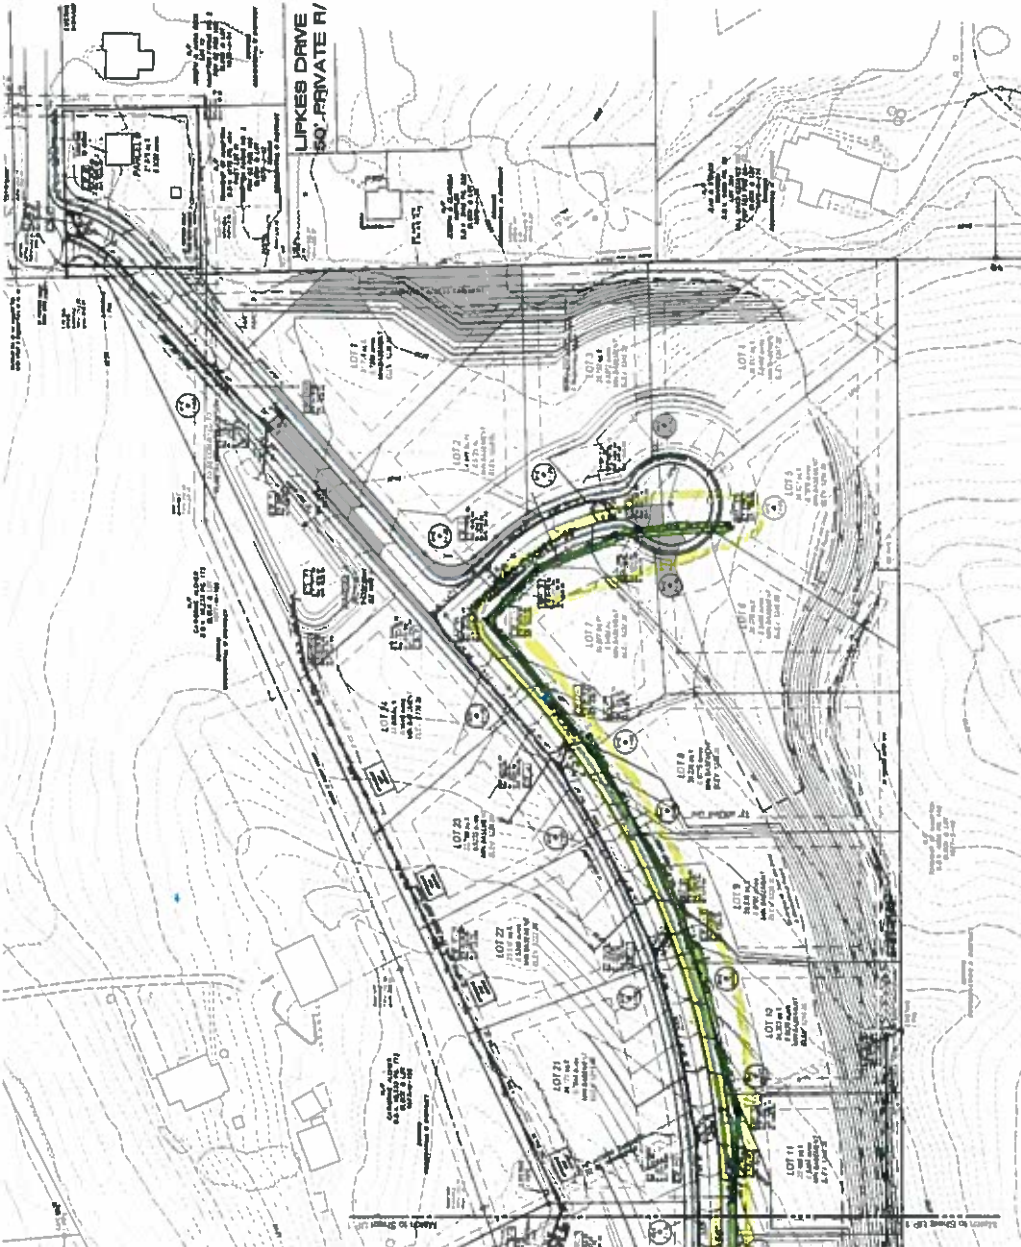


EXHIBIT A



EXHIBIT